


"AS BUILT "
FOUNDATION PLAN
64 WEST STREET
DOUGLAS, MA.

CIVIL SITE ENGINEERING, LLC.
128 WEST HARTFORD AVE.
UXBRIDGE, MA 01569
508-278-5091

NOTE:

THIS PLAN IS NOT TO BE USED TO ESTABLISH PROPERTY LINES AND IS NOT TO BE RECORDED AT THE REGISTRY OF DEEDS.

FOR SDCC LLC
DATE: OCTOBER 21, 2013 SCALE: 1" = 40'
A. M. #162 ; PART OF #15
ZONE: VR

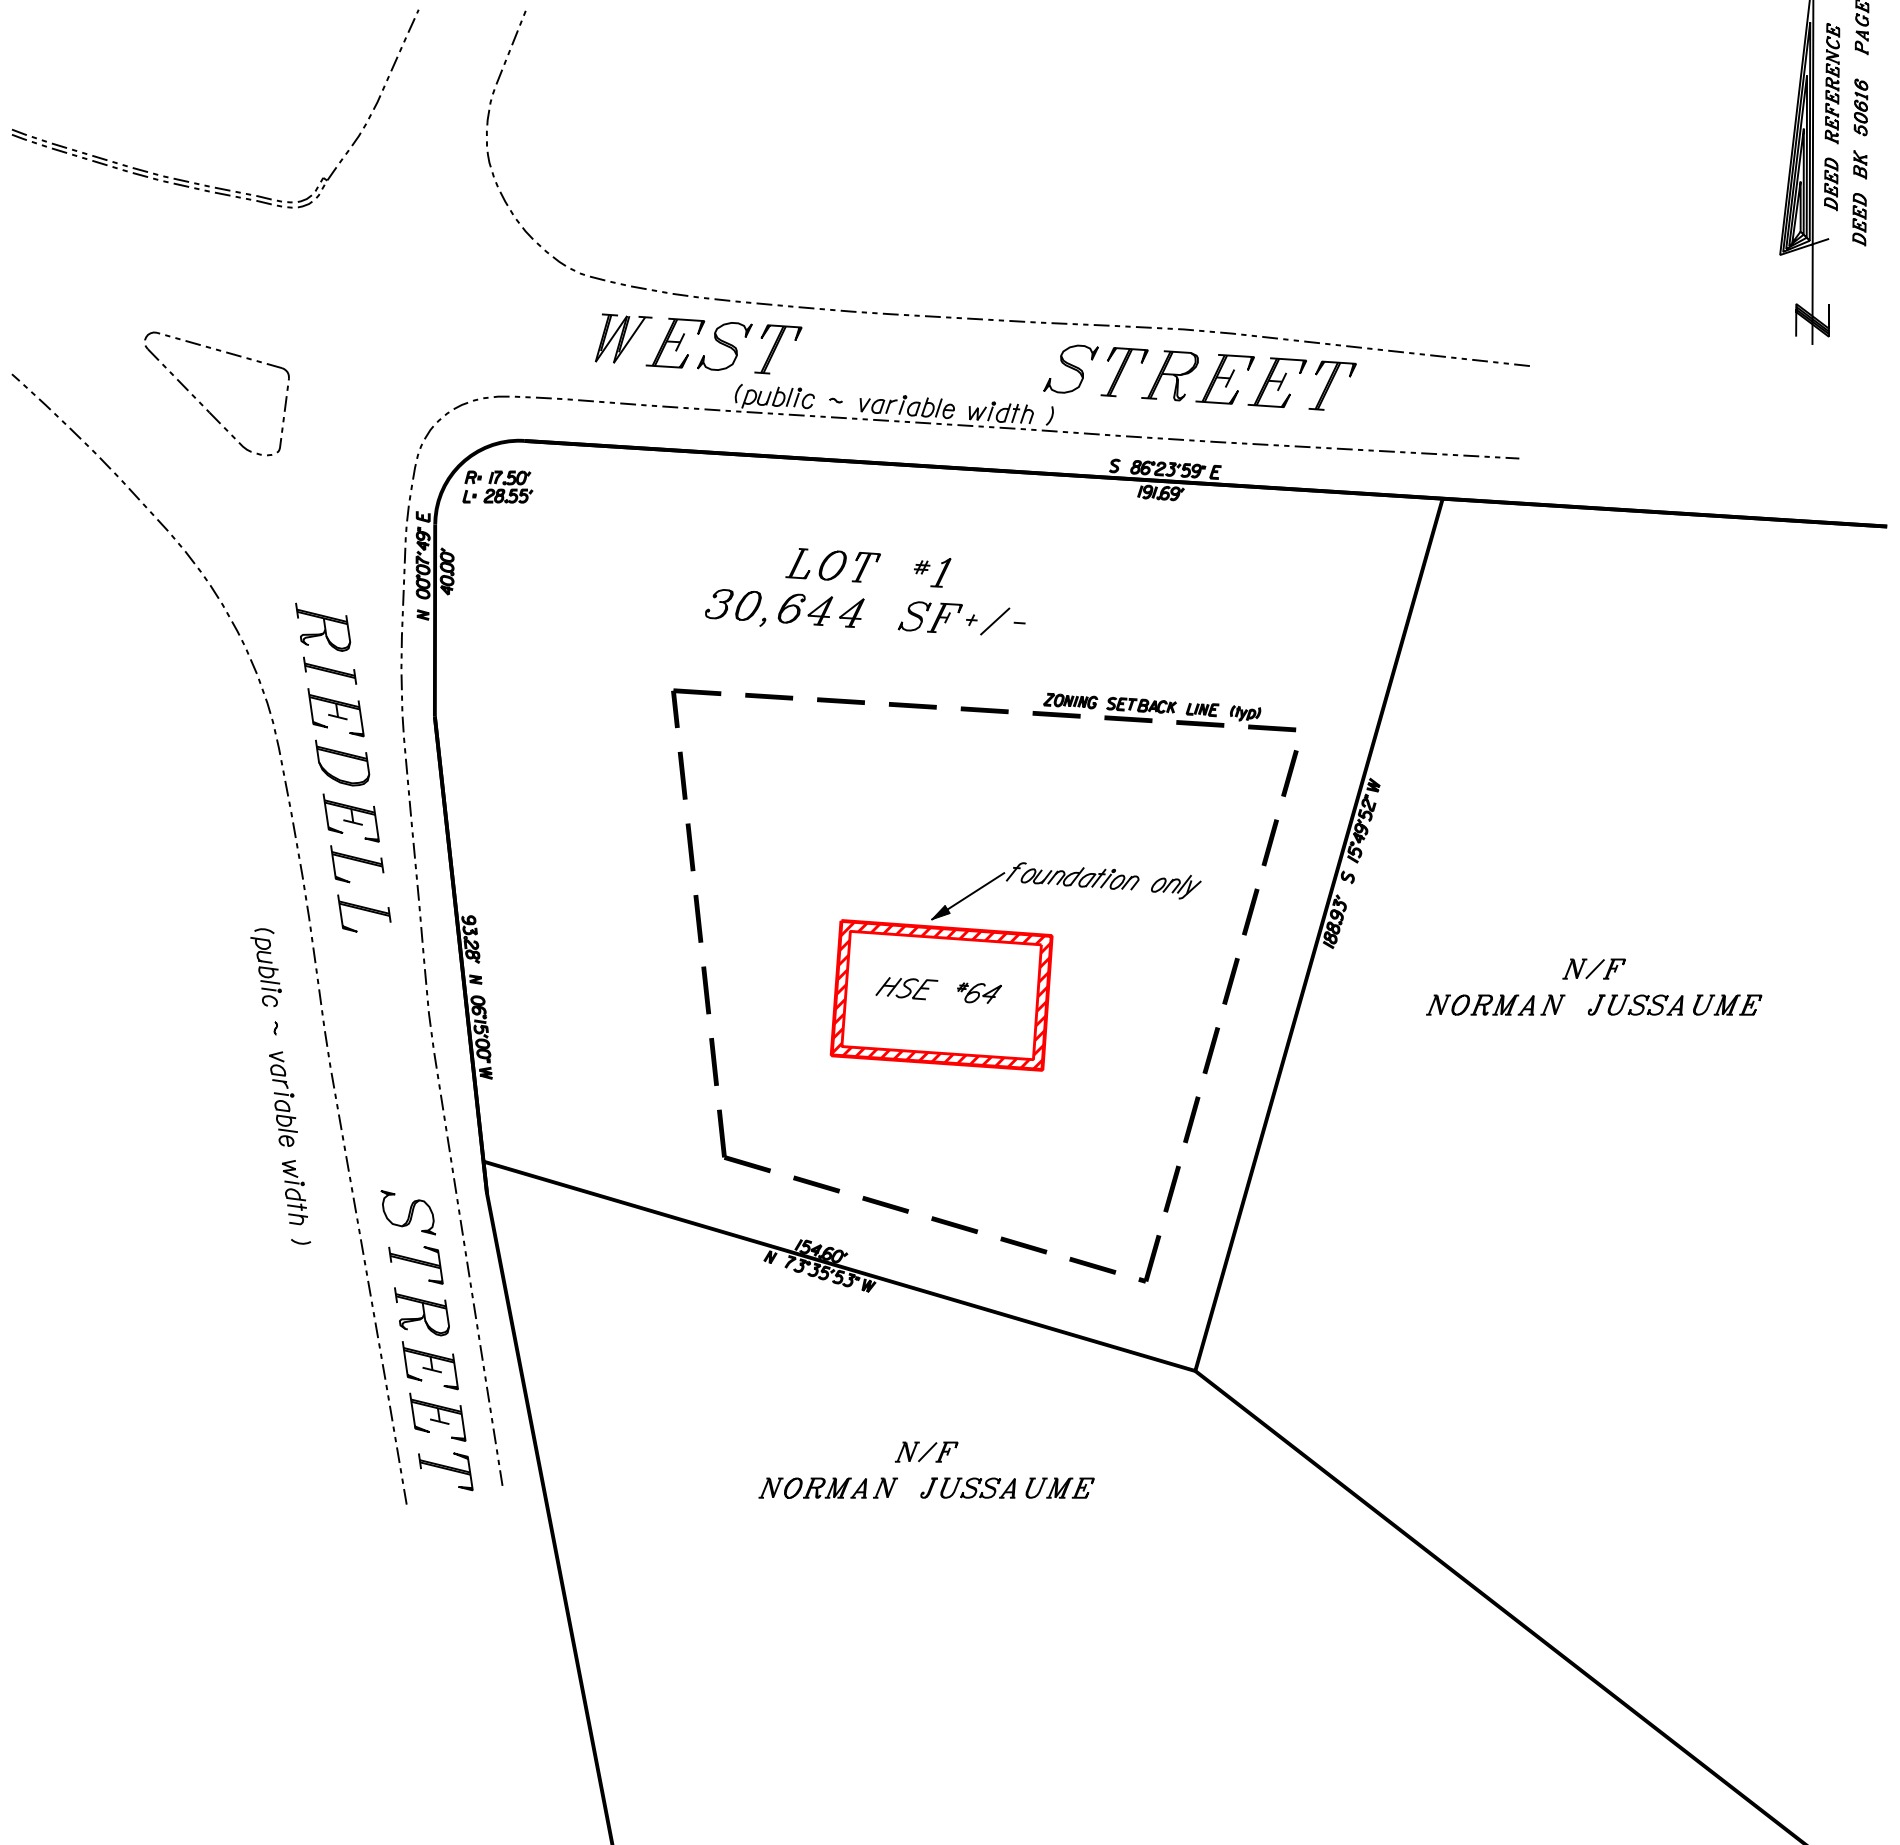

10/21/2013

DATE